

ABBREVIATIONS

A	AMPERE
AC	ABOVE COUNTER, ALTERNATING CURRENT
AF	AMP FUSE; AMP FRAME
AFF	ABOVE FINISHED FLOOR
AHJ	AUTHORITIES HAVING JURISDICTION
AIC	AMPERE INTERRUPTING CURRENT
AL	ALUMINIUM
AS	AMP SWITCH
AT	AMP TRIP
ATS	AUTOMATIC TRANSFER SWITCH
AV	AUDIO VISUAL
C	CONDUIT; DEGREES CELSIUS
CAT	CATEGORY
CCTV	CLOSED CIRCUIT TELEVISION
CJ	COPPER
DWG	DRAWING
(E)	EXISTING
EC	ELECTRICAL CONTRACTOR, END CAP
EF	EXHAUST FAN
ELEC	ELECTRICAL
EPO	EMERGENCY POWER OFF
EQ,EQUIP	EQUIPMENT
EVC	EV CAPABLE STALLS
EVO	EV STALLS WITH OPERABLE FAST CHARGERS
EVR	EV READY STALLS
EWC	ELECTRIC WATER COOLER
EWH	ELECTRIC WATER HEATER
FA	FIRE ALARM
FAAP	FIRE ALARM ANNUNCIATOR PANEL
FACP	FIRE ALARM CONTROL PANEL
FBO	FURNISHED BY OWNER
FOIC	FURNISHED BY OWNER INSTALLED BY CONTRACTOR
FOIO	FURNISHED BY OWNER INSTALLED BY OWNER
FSD	FIRE SMOKE DAMPER
FT	FOOT; FEET
G, GND	GROUND
GC	GENERAL CONTRACTOR
GFI	GROUND FAULT INTERRUPTER
GFCI	GROUND FAULT CIRCUIT INTERRUPTER
HP	HORSE POWER
IBC	INTERNATIONAL BUILDING CODE
JB	JUNCTION BOX
KVA	KILOVOLT AMPERE
KW	KILOWATT
KCMIL	THOUSAND CIRCULAR MILS
LCP	LIGHTING CONTROL PANEL
LTG	LIGHTING
LF	LINEAL FOOT
MAX	MAXIMUM
MCB	MAIN CIRCUIT BREAKER
MDP	MAIN DISTRIBUTION PANEL
MIN	MINIMUM
MLO	MAIN LUGS ONLY
MSB	MAIN SWITCHBOARD
MTD	MOUNTED
N	NEUTRAL
(N)	NEW
NEC	NATIONAL ELECTRICAL CODE
NEMA	NATIONAL ELECTRICAL MANUFACTURERS ASSOCIATION
NL	NIGHT LIGHT
NTS	NOT TO SCALE
OC	ON CENTER
OH	OVERHEAD LINE
OS	OCCUPANCY SENSOR
PIV	POST INDICATOR VALVE
QTY	QUANTITY
REV	REVISION
SCL	SEATTLE CITY LIGHT
SF	SQUARE FOOT, SUPPLY FAN
SMR	SURFACE METAL RACEWAY
SPO	SURGE PROTECTOR DEVICE
(TVSS)	(TRANSIENT VOLTAGE SURGE SUPPRESSOR)
SPEC	SPECIFICATION
TBB	TELECOMMUNICATIONS BACKBOARD
TBD	TO BE DETERMINED
TYP	TYPICAL
UG	UNDERGROUND
UNO	UNLESS NOTED OTHERWISE
V	VOLTS
VAV	VARIABLE AIR VOLUME
VFD	VARIABLE FREQUENCY DRIVE
W	WATT; WIRE
WP	WEATHERPROOF
XFMR	TRANSFORMER
Y	WYE


FIRE ALARM

CLG	WALL	
MTD	MTD	
N/A	[F]	MANUAL PULL STATION
N/A	[H]	FIRE ALARM HORN
	[L]	FIRE ALARM STROBE
(S)	▽ [S]	FIRE ALARM SPEAKER
(F)	▽ [F]	FIRE ALARM HORN/STROBE
	▽ [FS]	FIRE ALARM SPEAKER/STROBE
[FARA]		FIRE ALARM REMOTE ANNUNCIATOR
[FACP]		FIRE ALARM CONTROL PANEL
(S)		FIRE ALARM SMOKE DETECTOR
(S) ^D		FIRE ALARM SMOKE DUCT DETECTOR
120V		RESIDENTIAL COMBINATION SMOKE ALARM/ CO DETECTOR
(SD)		FIRE ALARM HEAT DETECTOR
(KB)		COMBINATION SMOKE/FIRE DAMPER
(TS)		FIRE KNOCK BOX
(FL)		TAMPER SWITCH
(V)		FLOW SWITCH
(M)		VALVE
(AS)		MAGNETIC DOOR HOLD OPEN
(PS)		ALARM SWITCH
		PRESSURE SWITCH

ANNOTATION

XXX-XX-XX	EQUIPMENT TAG
1	FLAG NOTE
X X.X	DETAIL / PLAN IDENTIFIER
#	REVISION CALLOUT
XXX	FEEDER TAG


FEEDER DESIGNATIONS

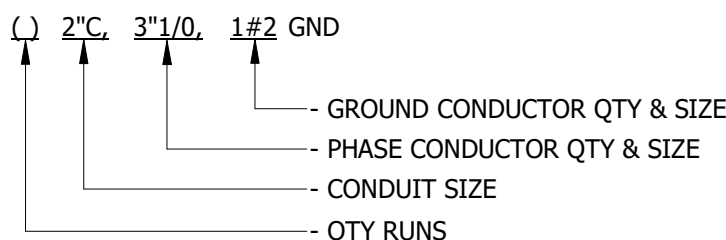


EXISTING CONSTRUCTION

EXISTING	DEMO	NEW	DESCRIPTION
⌀	⌀	⌀	DUPLEX RECEPTACLE


SCHEMATIC / ONE LINE

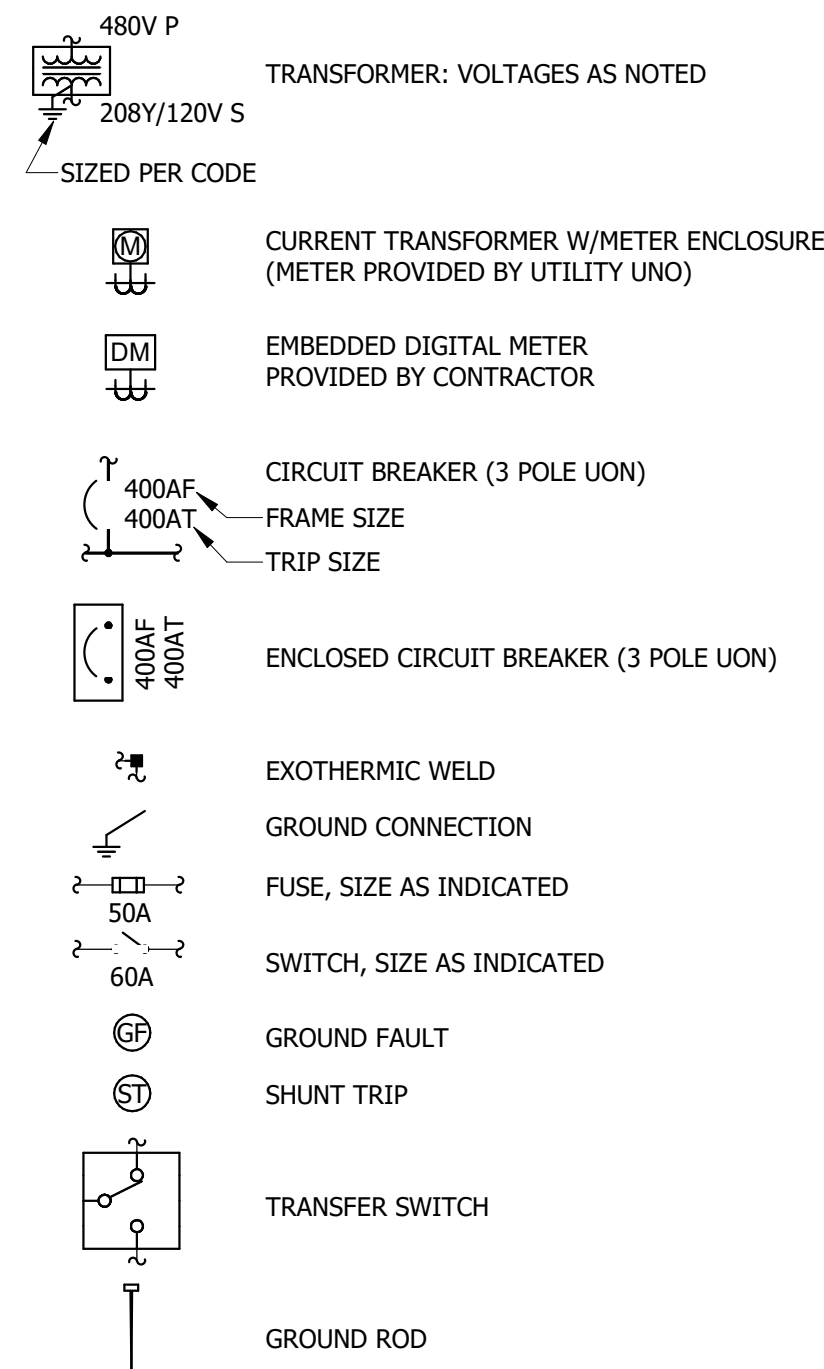

GROUNDING

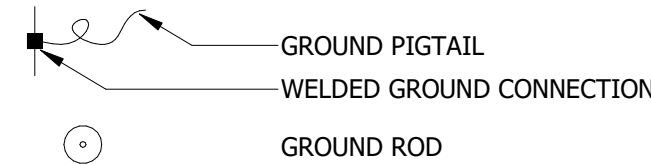

WIRING

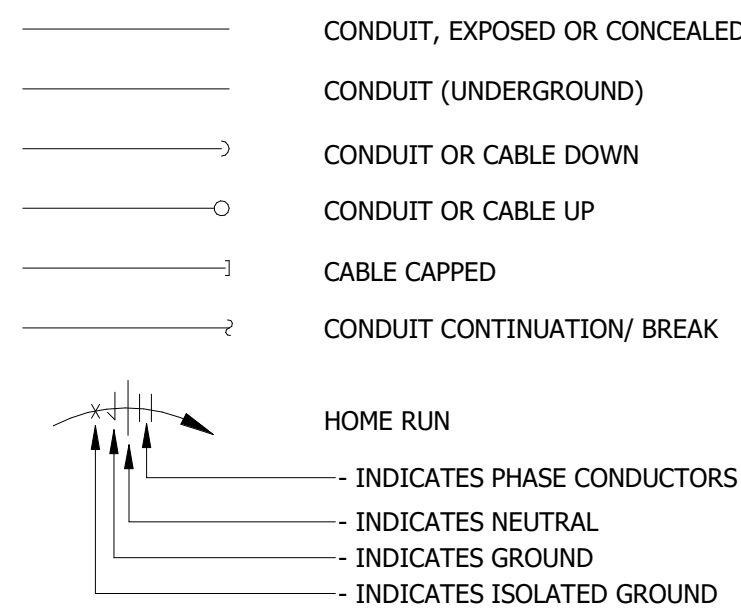

DATA / COMMUNICATION

▼	DATA OUTLET W/ (1) CAT-6 CABLE.
▼	WALL PHONE OUTLET, MOUNT AT +48", W/(1) CAT 6 CABLE
▽	BROADBAND COAX OUTLET W/ (1) RG-6 CABLE
📹	CAMERA
CR	CARD READER
◆	INTERCOM STATION - FOR RESCUE ASSISTANCE. CONNECT TO HEAD-END SYSTEM WITH CAT5E CABLE.
RR	RADIO READER; CONFIRM REQUIREMENTS WITH SECURITY VENDOR
SB	SMART BOX (APARTMENT DISTRIBUTION FRAME) WITH RECEPTACLE

OUTLET MOUNTING HEIGHTS

RECEPTACLES	+18 INCHES VERTICAL
LIGHT SWITCHES	+48 INCHES VERTICAL
PANEL BOARDS	+4 FEET TO THE HIGHEST CIRCUIT BREAKER OR PANEL
ADA PANEL BOARDS	+4 FEET TO THE HIGHEST CIRCUIT BREAKER OR PANEL
TELECOM OUTLET-DESK	+18 INCHES VERTICAL
TELECOM OUTLET-WALL	+18 INCHES VERTICAL
MANUAL STATION	+40 INCHES VERTICAL
FIRE ALARM CONTROL PANEL	+6 FEET TO TOP
FIRE ALARM VISUAL ALARM LIGHT	+80 INCHES OR 6 INCHES BELOW CEILING, WHICHEVER IS LOWER
FIRE ALARM SPEAKER HORN, CHIME	+80 INCHES OR 6 INCHES BELOW CEILING, WHICHEVER IS LOWER

POWER (P&LV)

⌀	RECEPTACLE OUTLET: SUBSCRIPT NUMBER INDICATES PANEL CIRCUIT NUMBER. SUBSCRIPT LETTER INDICATES: WP-WEATHER PROOF
⌀	DUPLEX RECEPTACLE
⌀	GFCI DUPLEX RECEPTACLE
⌀	FOURPLEX RECEPTACLE
⌀	GFCI FOURPLEX RECEPTACLE
⌀	DUPLEX RECEPTACLE - HALF SWITCH
⌀	CEILING DUPLEX RECEPTACLE
⌀	ABOVE COUNTER DUPLEX RECEPTACLE
⌀	ABOVE COUNTER FOURPLEX RECEPTACLE
⌀	DUPLEX RECEPTACLE ON EMERGENCY CIRCUIT
⌀	QUADPLEX RECEPTACLE ON EMERGENCY CIRCUIT
👁️	POKE-THRU, DEVICES AS INDICATED. F - FLUSH MOUNTED
👁️	FLOOR BOX, DEVICES AS INDICATED
▶️	POWER POLE
🔌	EQUIPMENT CONNECTION
🔌	SPECIAL PURPOSE RECEPTACLE, DEVICE RATING AS SHOWN
🔌	J-BOX
🔌	NON-FUSED DISCONNECT. SIZE AS INDICATED
🔌	FUSED DISCONNECT. AMP FUSE SIZE (40 AF), AMP SWITCH SIZE (60 AS)
🔌	MOTOR STARTER
🔌	COMBINATION MOTOR STARTER - DISCONNECT SWITCH
🔌	SHUNT TRIP CIRCUIT BREAKER
🔌	MOTOR CONNECTION
🔌	MOTOR CONNECTION - 3 PHASE

POWER (P&LV) CON'T

🔌	480Y/277V ELECTRICAL PANEL
🔌	208Y/120V ELECTRICAL PANEL
🔌	SURFACE MOUNTED RACEWAY WITH DEVICE AS SHOWN, OR WITH SPACING INDICATED
🔌	DOOR CONTACT

LIGHTING

🔌	WALL SWITCH - SUBSCRIPT INDICATES: 3 = 3-WAY, 4 = 4-WAY, LV = LOW-VOLTAGE, NS = NIGHT SETBACK, a = LOWER CASE LETTERS INDICATES SWITCHING GROUP DESIGNATION, T = TIMER, OS = OCCUPANCY SENSOR
🔌	DIMMER SWITCH
🔌	DAYLIGHT SENSOR
🔌	OCCUPANCY SENSOR, CEILING MOUNTED
🔌	OCCUPANCY SENSOR, WALL MOUNTED
🔌	LIGHT FIXTURE, SIZES VARY. REFER TO FIXTURE TYPE. TYPICAL ALL FIXTURES: ADJACENT NUMBER INDICATES CIRCUIT GROUPING, LOWER CASE LETTER INDICATES SWITCHING GROUP
🔌	FIXTURE ON EMERGENCY CIRCUIT. SIZE VARIES, REFER TO FIXTURE TYPE.
🔌	WALL-MOUNTED FIXTURE. SIZE VARIES, REFER TO FIXTURE TYPE.
🔌	WALL MOUNTED FIXTURE ON EMERGENCY CIRCUIT. SIZE VARIES, REFER TO FIXTURE TYPE.
🔌	STRIP FIXTURE. SIZE VARIES, REFER TO FIXTURE TYPE.
🔌	STRIP FIXTURE ON EMERGENCY CIRCUIT. SIZE VARIES, REFER TO FIXTURE TYPE.
🔌	RECESSED DOWNLIGHT FIXTURE
🔌	RECESSED WALL WASH/ADJUSTABLE FIXTURE
🔌	DOWNLIGHT ON EMERGENCY CIRCUIT
🔌	STEP LIGHTS
🔌	TRACK LIGHTING, LENGTH AS INDICATED
🔌	PENDANT LIGHT
🔌	FAA OBSTRUCTION LIGHT
🔌	FAA OBSTRUCTION LIGHT - DOUBLE
🔌	WALL SCONCE
🔌	ILLUMINATED EXIT SIGN - FACES & DIRECTION OF ALL ARROWS AS SHOWN, WHERE INDICATED
🔌	TROFFER
🔌	SURFACE DOWNLIGHT
🔌	SURFACE WALL WASH/ADJUSTABLE DOWNLIGHT
🔌	LINEAR PENDANT
🔌	LINEAR WALL WASH

PROJECT ADDRESS

2372 E 7TH AVENUE
PORT ANGELES, WAS 98362

PARCEL#



VICINITY MAP

NOT TO SCALE

SHEET INDEX - ELECTRICAL

SHEET NUMBER	SHEET NAME	SHEET SCALE	ADDENDUM 02 08/21/26
E0.01	ELECTRICAL LEGEND & ABBREVIATIONS	NTS	X
E0.10	POWER RISER	NTS	X
E0.14	TELECOM AND GROUNDING RISERS	NTS	X
E0.12	ELECTRICAL LOAD CALCULATIONS	NTS	X
E0.13	PANEL SCHEDULES	NTS	X
E0.14	PANEL SCHEDULES	NTS	X
E0.15	PANEL SCHEDULES	NTS	X
E0.20	LUMINAIRE SCHEDULE	NTS	X
E0.30	CONTROL SEQUENCE OF OPERATIONS	NTS	X
E0.40	WSEC 2021 ENERGY CODE FORMS	NTS	X
E11.01	ELECTRICAL SITE PLAN	1" = 10'-0"	X
E22.01	P&LV PLAN - LEVEL 1	1/8" = 1'-0"	X
E22.02	P&LV PLAN - LEVEL 2	1/8" = 1'-0"	X
E25.01	P&LV PLAN - ROOF	1/8" = 1'-0"	X
E31.01	LIGHTING SITE PLAN	1" = 10'-0"	X
E32.01	LIGHTING PLAN - LEVEL 1	1/8" = 1'-0"	X
E32.02	LIGHTING PLAN - LEVEL 2	1/8" = 1'-0"	X
E36.01	ELECTRICAL DETAILS	1/8" = 1'-0"	X
E46.00	ENLARGED ELECTRICAL PLANS	NTS	X
E46.01	ENLARGED UNIT PLANS	NTS	X
E46.02	ENLARGED UNIT PLANS	NTS	X

MISCELLANEOUS

🔌	KEY PAD
🔌	PUSH BUTTON DOOR OPERATOR
🔌	EMERGENCY POWER OFF SWITCH
🔌	CLOCK
🔌	DOOR HOLDER - CLOSER
🔌	DOOR RELEASE
🔌	EQUIPMENT AS NOTED
🔌	THERMOSTAT
🔌	DESTINATION DISPATCH

PROJECT #	2023093.02
ADDENDUM 02	
ISSUE DATE	AUGUST 21, 2026
REVISION SCHEDULE	
1	PERMIT SET 07/26/2026
2	ADDENDUM 02 08/21/2026



ELECTRICAL LEGEND & ABBREVIATIONS

PANEL: DP-1						VOLTS: 120/208 Wye						A.I.C.						
LOCATION: ELECTRICAL 104						PHASES: 3						MAINS TYPE: MLO						
SUPPLY FROM: MSB						WIRES: 4						BUSS RATING: 225 A						
MOUNTING: Surface												MCB RATING: 225 A						
ENCLOSURE: Type 1																		
CKT	NOTE	CIRCUIT DESCRIPTION	TYPE	TRIP	POLES	A		B		C		POLES	TRIP	TYPE	CIRCUIT DESCRIPTION	NOTE	CKT	
1		EWH-1-1	H	50 A	2	9.00	4.43					3	60 A	E	AWHP-1-1		2	
3								9.00	4.43									4
5										0.07	4.43							6
7		CP-1-1	M	20 A	3	0.07	0.34					3	20 A	M	DBP-1-1		8	
9								0.07	0.34									10
11										0.65	0.34							12
13		EDH-1-1	E	20 A	2							1	20 A	H	EH-1-4		14	
15		EH-1-1	H	20 A	1			0.50	0.50			1	20 A	H	EH-1-5		16	
17		EH-1-2	H	20 A	1					0.50	0.29	1	20 A	E	ERV-1-1		18	
19		EH-1-3	H	20 A	1	1.00	0.29					1	20 A	E	ERV-1-2		20	
21		TMV-1-1	R	20 A	1			0.18	0.27			1	20 A	M	FN-1-1		22	
23		LVL 1 TECHNICAL ROOMS REC	R	20 A	1					1.08	1.08	1	20 A	R	LVL 1 CORRIDOR REC		24	
25		EDH-2-1	H	20 A	2	2.50	1.00					1	20 A	H	EH-2-2		26	
27								2.50	1.00			1	20 A	H	EH-2-3		28	
29										1.00	1.08	1	20 A	R	LVL 2 COORDIOR REC		30	
31		ERV-2-1	E	20 A	1	0.29	0.72					1	20 A	R	LVL 2 TECHNICAL ROOMS REC		32	
33		ERV-2-2	E	20 A	1			0.29	0.18			1	20 A	R	MOISTURE SENSOR		34	
35		DHW METERING	R	20 A	1					0.18	0.25	1	20 A	H	MD-2-1		36	
37		ENTRY/STAIRWELL LIGHTING		20 A	1	0.14	0.03					1	20 A		EXTERIOR LIGHTING		38	
39		LVL 1 CORRIDOR LIGHTING		20 A	1			0.14	0.10			1	20 A		LVL 1 CORRIDOR LIGHTING		40	
41		MECH/LAUNDRY ROOMS		20 A	1					0.21	0.17	1	20 A		STAIRWELL/EXTERIOR LIGHTING		42	
43		LVL 2 COORIDOR/LAUNDRY LIGHTING		20 A	1	0.17	0.18					1	20 A	R	ACCESS CONTROL PANEL		44	
45		LVL 2 CORRIDOR LIGHTING		20 A	1			0.18	0.01			1	20 A	M	LVL 1 TRAP PRIMER		46	
47		SITE POLE LIGHTING		20 A	1					0.16	0.01	1	20 A	M	LVL 2 TRAP PRIMER		48	
49		MONUMENT SIGN		20 A	1	1.00	2.00					1	30 A	R	BUILDING SIGNAGE		50	
51		MOTORIZED GATE	M	20 A	2			3.33	0.00			1	20 A	--	SPARE		52	
53								3.33	0.00	1	20 A	--	SPARE		54			
TOTAL LOAD:						24.81 kVA		23.04 kVA		14.83 kVA								
TOTAL AMPS:						217 A		202 A		124 A								
LOAD SUMMARY		LOAD TYPE	CONNECTED LOAD		DEMAND FACTOR		DEMAND		PANEL TOTALS									
LIGHTING		L	2.295 kVA		125.00%		2.869 kVA											
MOTOR		M	1.536 kVA		100.00%		1.536 kVA		TOTAL CONNECTED LOAD: 62.67 kVA									
RECEPTACLE		R	6.680 kVA		100.00%		6.680 kVA		TOTAL DEMAND LOAD: 64.91 kVA									
CONTINUOUS (HEATING/EQUIPMENT)		E	15.752 kVA		100.00%		15.752 kVA		TOTAL CONNECTED AMPS: 174 A									
MISC (EQUIPMENT/OTHER)		Other	0.000 kVA		0.00%		0.000 kVA		TOTAL ESTIMATED DEMAND: 180 A									
KITCHEN		K	0.000 kVA		0.00%		0.000 kVA											
ELECTRIC VEHICLE CHARGING		Electrical Vehicle...	0.000 kVA		0.00%		0.000 kVA											
NOTES:																		

EKLUND AT GALES

PENINSULA HOUSING AUTHORITY


2372 E 7TH AVENUE
PORT ANGELES, WAS 98362

DATE/TIME PRINTED: 8/20/2026 4:04:36 PM
Autodesk Docs/Peninsula Housing Authority - EklundMEP25_24021840.00_Peninsula Housing Authority_C.rvt

1

ELETRICAL SITE PLAN

SCALE
1" = 10' - 0"
0 5' - 0" 10' - 0" 20' - 0"

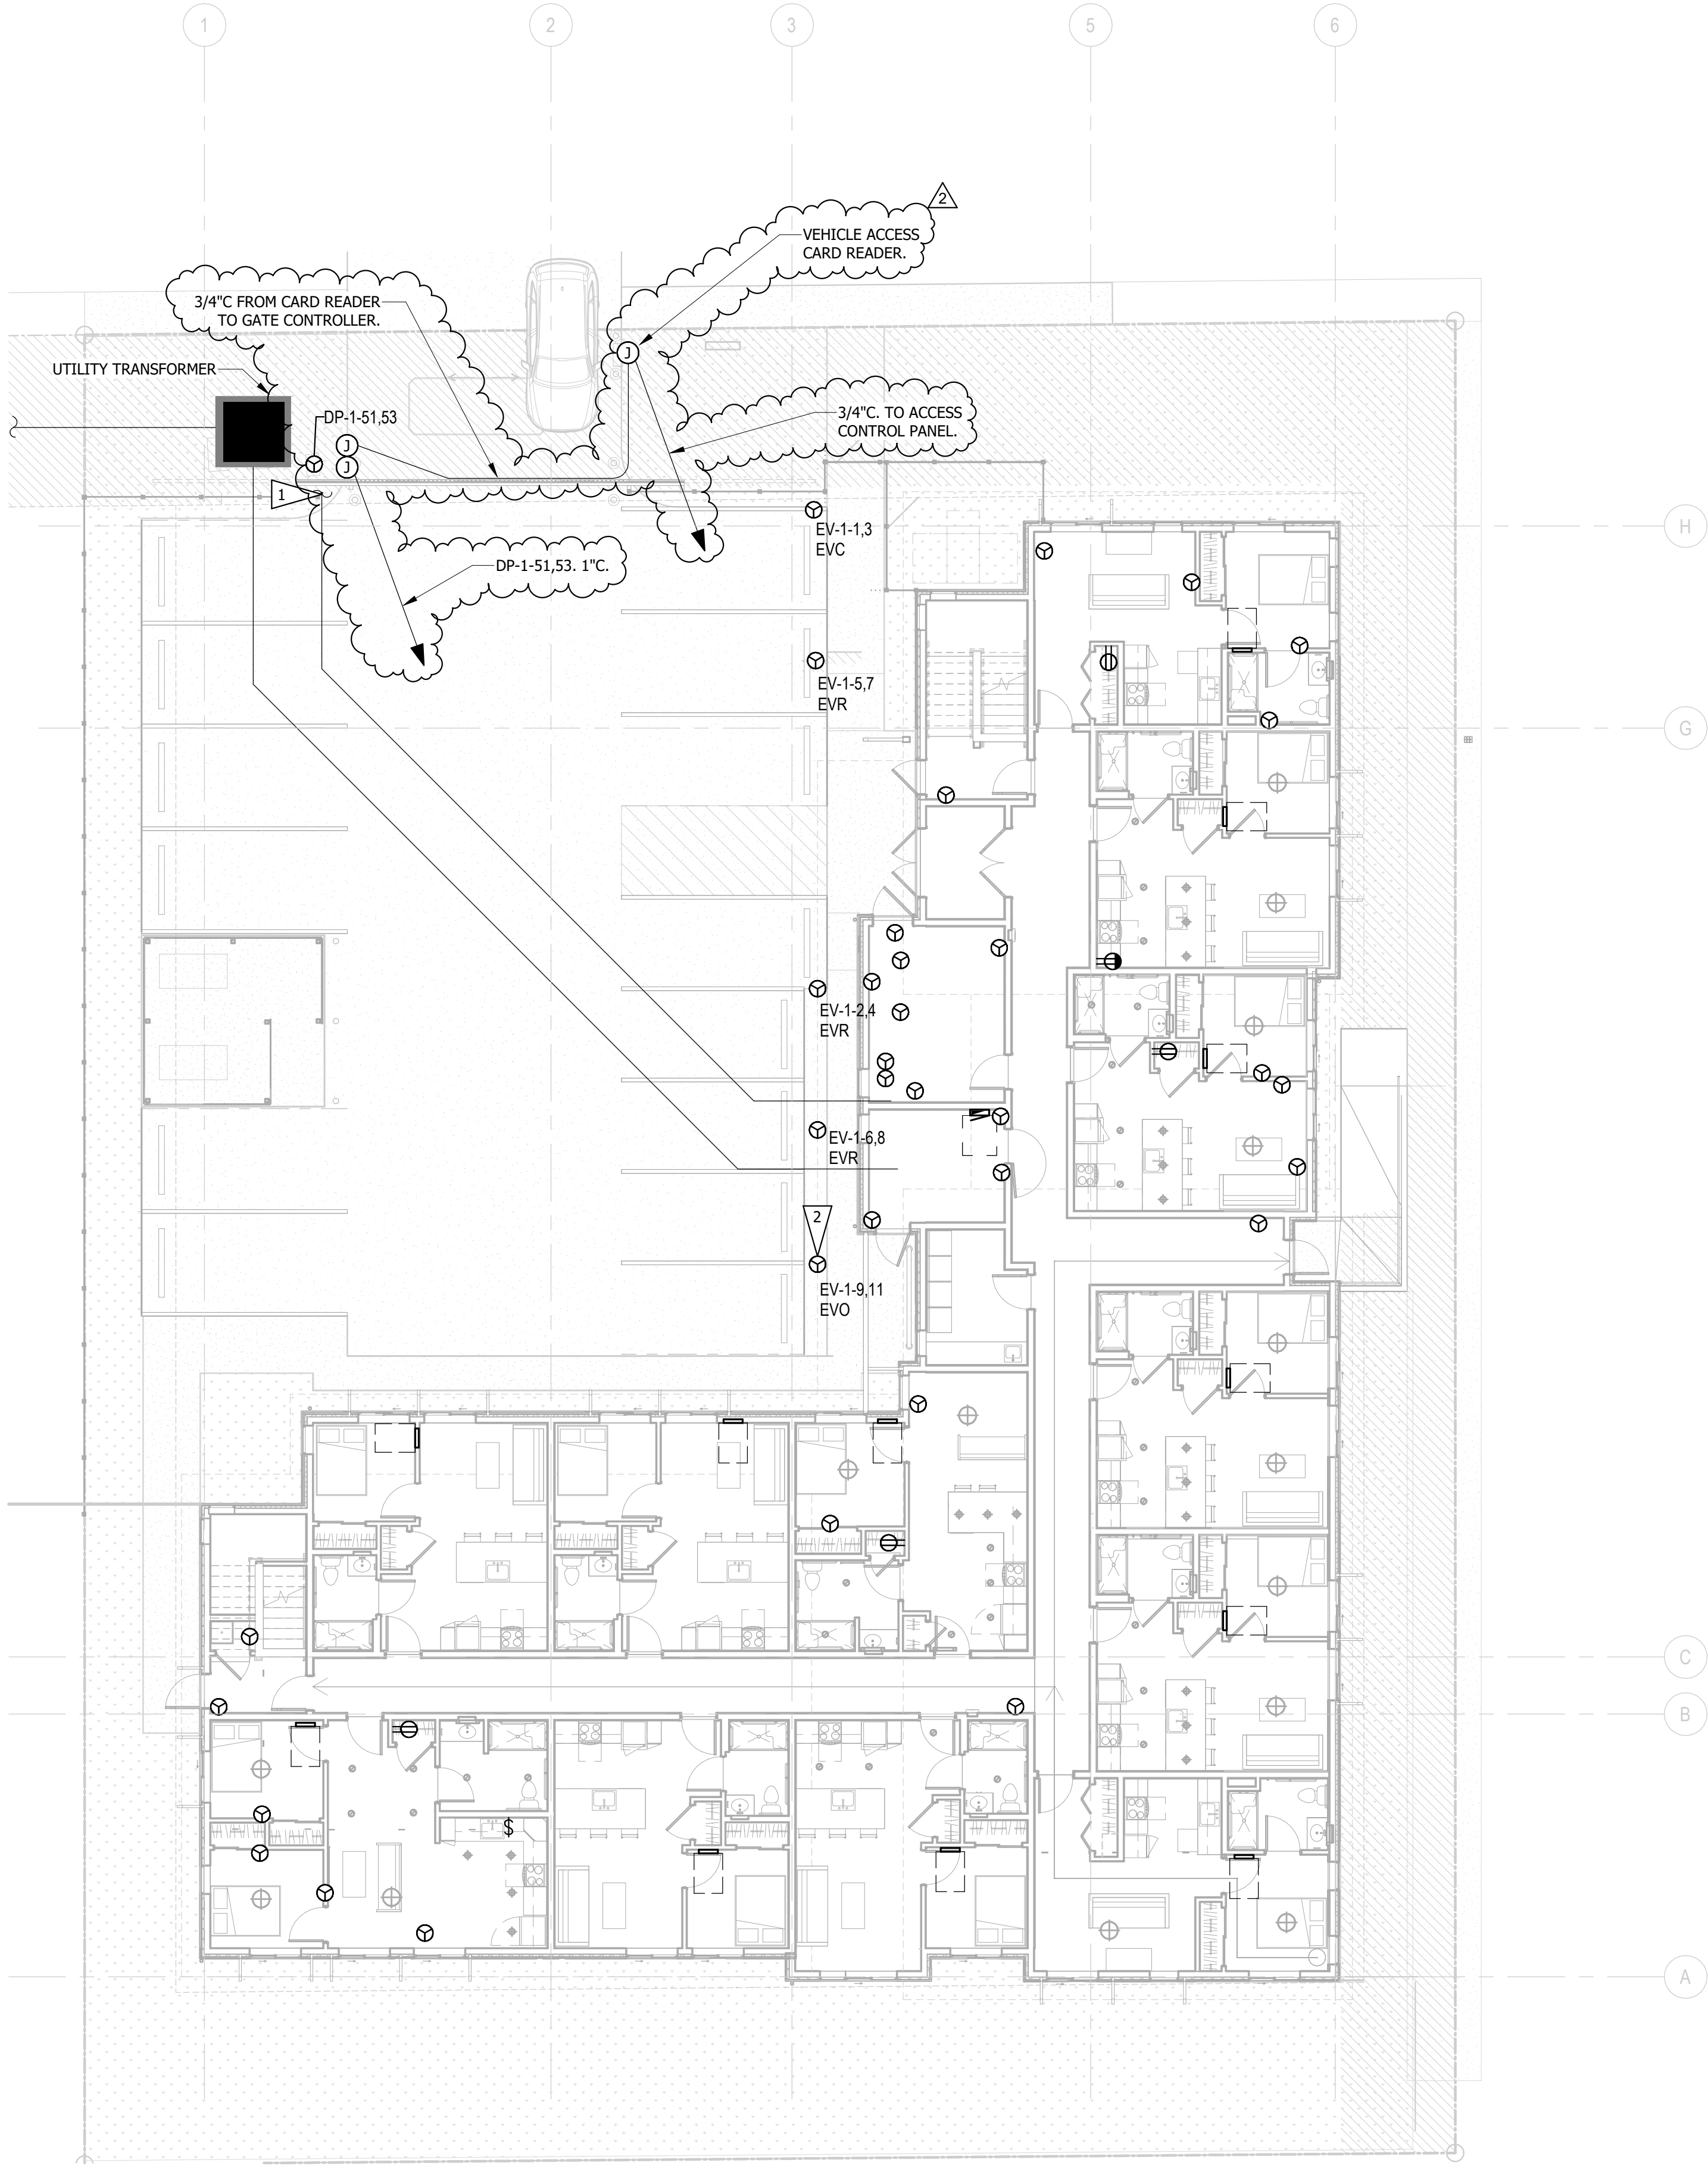

SHEET KEYNOTES

- 1 COMMUNICATIONS SERVICE PEDESTAL AND VEHICLE GATE OPERATOR. FINAL LOCATION. CONDUIT SIZING AND ROUTING FROM PEDESTAL TO TELEPHONE BOARD TO BE COORDINATED WITH UTILITY.
- 2 DUAL HEAD EV CHARGER TO BE INSTALLED AT THIS LOCATION.

RICEfergusMILLER

ARCHITECTURE INTERIORS PLANNING VIZLAB

275 FIFTH STREET, SUITE 100
BREMERTON, WA 98337
360-377-8773
RFMARCH.COM



www.imegcorp.com
1721 8TH AVE. N.
SEATTLE, WA 98109
P: 206.262.7100
PROJECT #24021840.00

EKLUND AT GALES
PENINSULA HOUSING AUTHORITY
2372 E 7TH AVENUE
PORT ANGELES, WAS 98362

PROJECT # 2023093.02

ADDENDUM 02

ISSUE DATE AUGUST 21, 2026

REVISION SCHEDULE


1	PERMIT SET	07/26/2026
2	ADDENDUM 02	08/21/2026

AHJ APPROVAL STAMP

ELECTRICAL SITE PLAN

SHEET #

 E11.01



EKLUND AT GALES
PENINSULA HOUSING AUTHORITY
2372 E 7TH AVENUE
PORT ANGELES, WA 98362


ГЭЭ 01

SHEET #

E22.01



P&LV PLAN - LEVEL 1
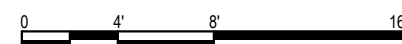
$$1/8'' = 1'-0''$$


DATE/ TIME PRINTED: 8/20/2026 4:04:38 PM
Autodesk Docs:/Peninsula Housing Authority - Eklund/MEF25_24021840.00_Peninsula Housing Authority_C-1v1

DATE/ TIME PRINTED: 8/20/2026 4:04:38 PM

EKLUND AT GALES
PENINSULA HOUSING AUTHORITY
2372 E 7TH AVENUE
PORT ANGELES, WAS 98362

[illegible]

AHJ APPROVAL STAMP

P&LV PLAN - LEVEL 2

SHEET #

E22.02


GENERAL SHEET NOTES

- A. PROVIDE CONDUIT AND WIRE, NM CABLE, OR MC CABLE FOR CIRCUITING SHOWN OR IMPLIED, ~~3" x 1/2 AWG~~, UNLESS OTHERWISE NOTED.
- B. FIRE ALARM DEVICES SHOWN FOR DESIGN INTENT ONLY. FINAL FIRE ALARM DESIGN BY DESIGN BUILD SUBCONTRACTOR.
- C. REFER TO MEP COORDINATION SCHEDULE FOR WIRING REQUIREMENTS AND ADDITIONAL INFORMATION ON MECHANICAL EQUIPMENT.



P&LV PLAN - LEVEL 2

1/8" = 1'-0"

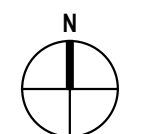


DATE/TIME PRINTED: 8/20/2026 4:04:40 PM
Autodesk Docs/Peninsula Housing Authority - EklundMEPS_24021840.00_Peninsula Housing Authority_C.rvt

1

LIGHTING SITE PLAN

SCALE
1" = 10' - 0"
0 5' - 0" 10' - 0" 20' - 0"

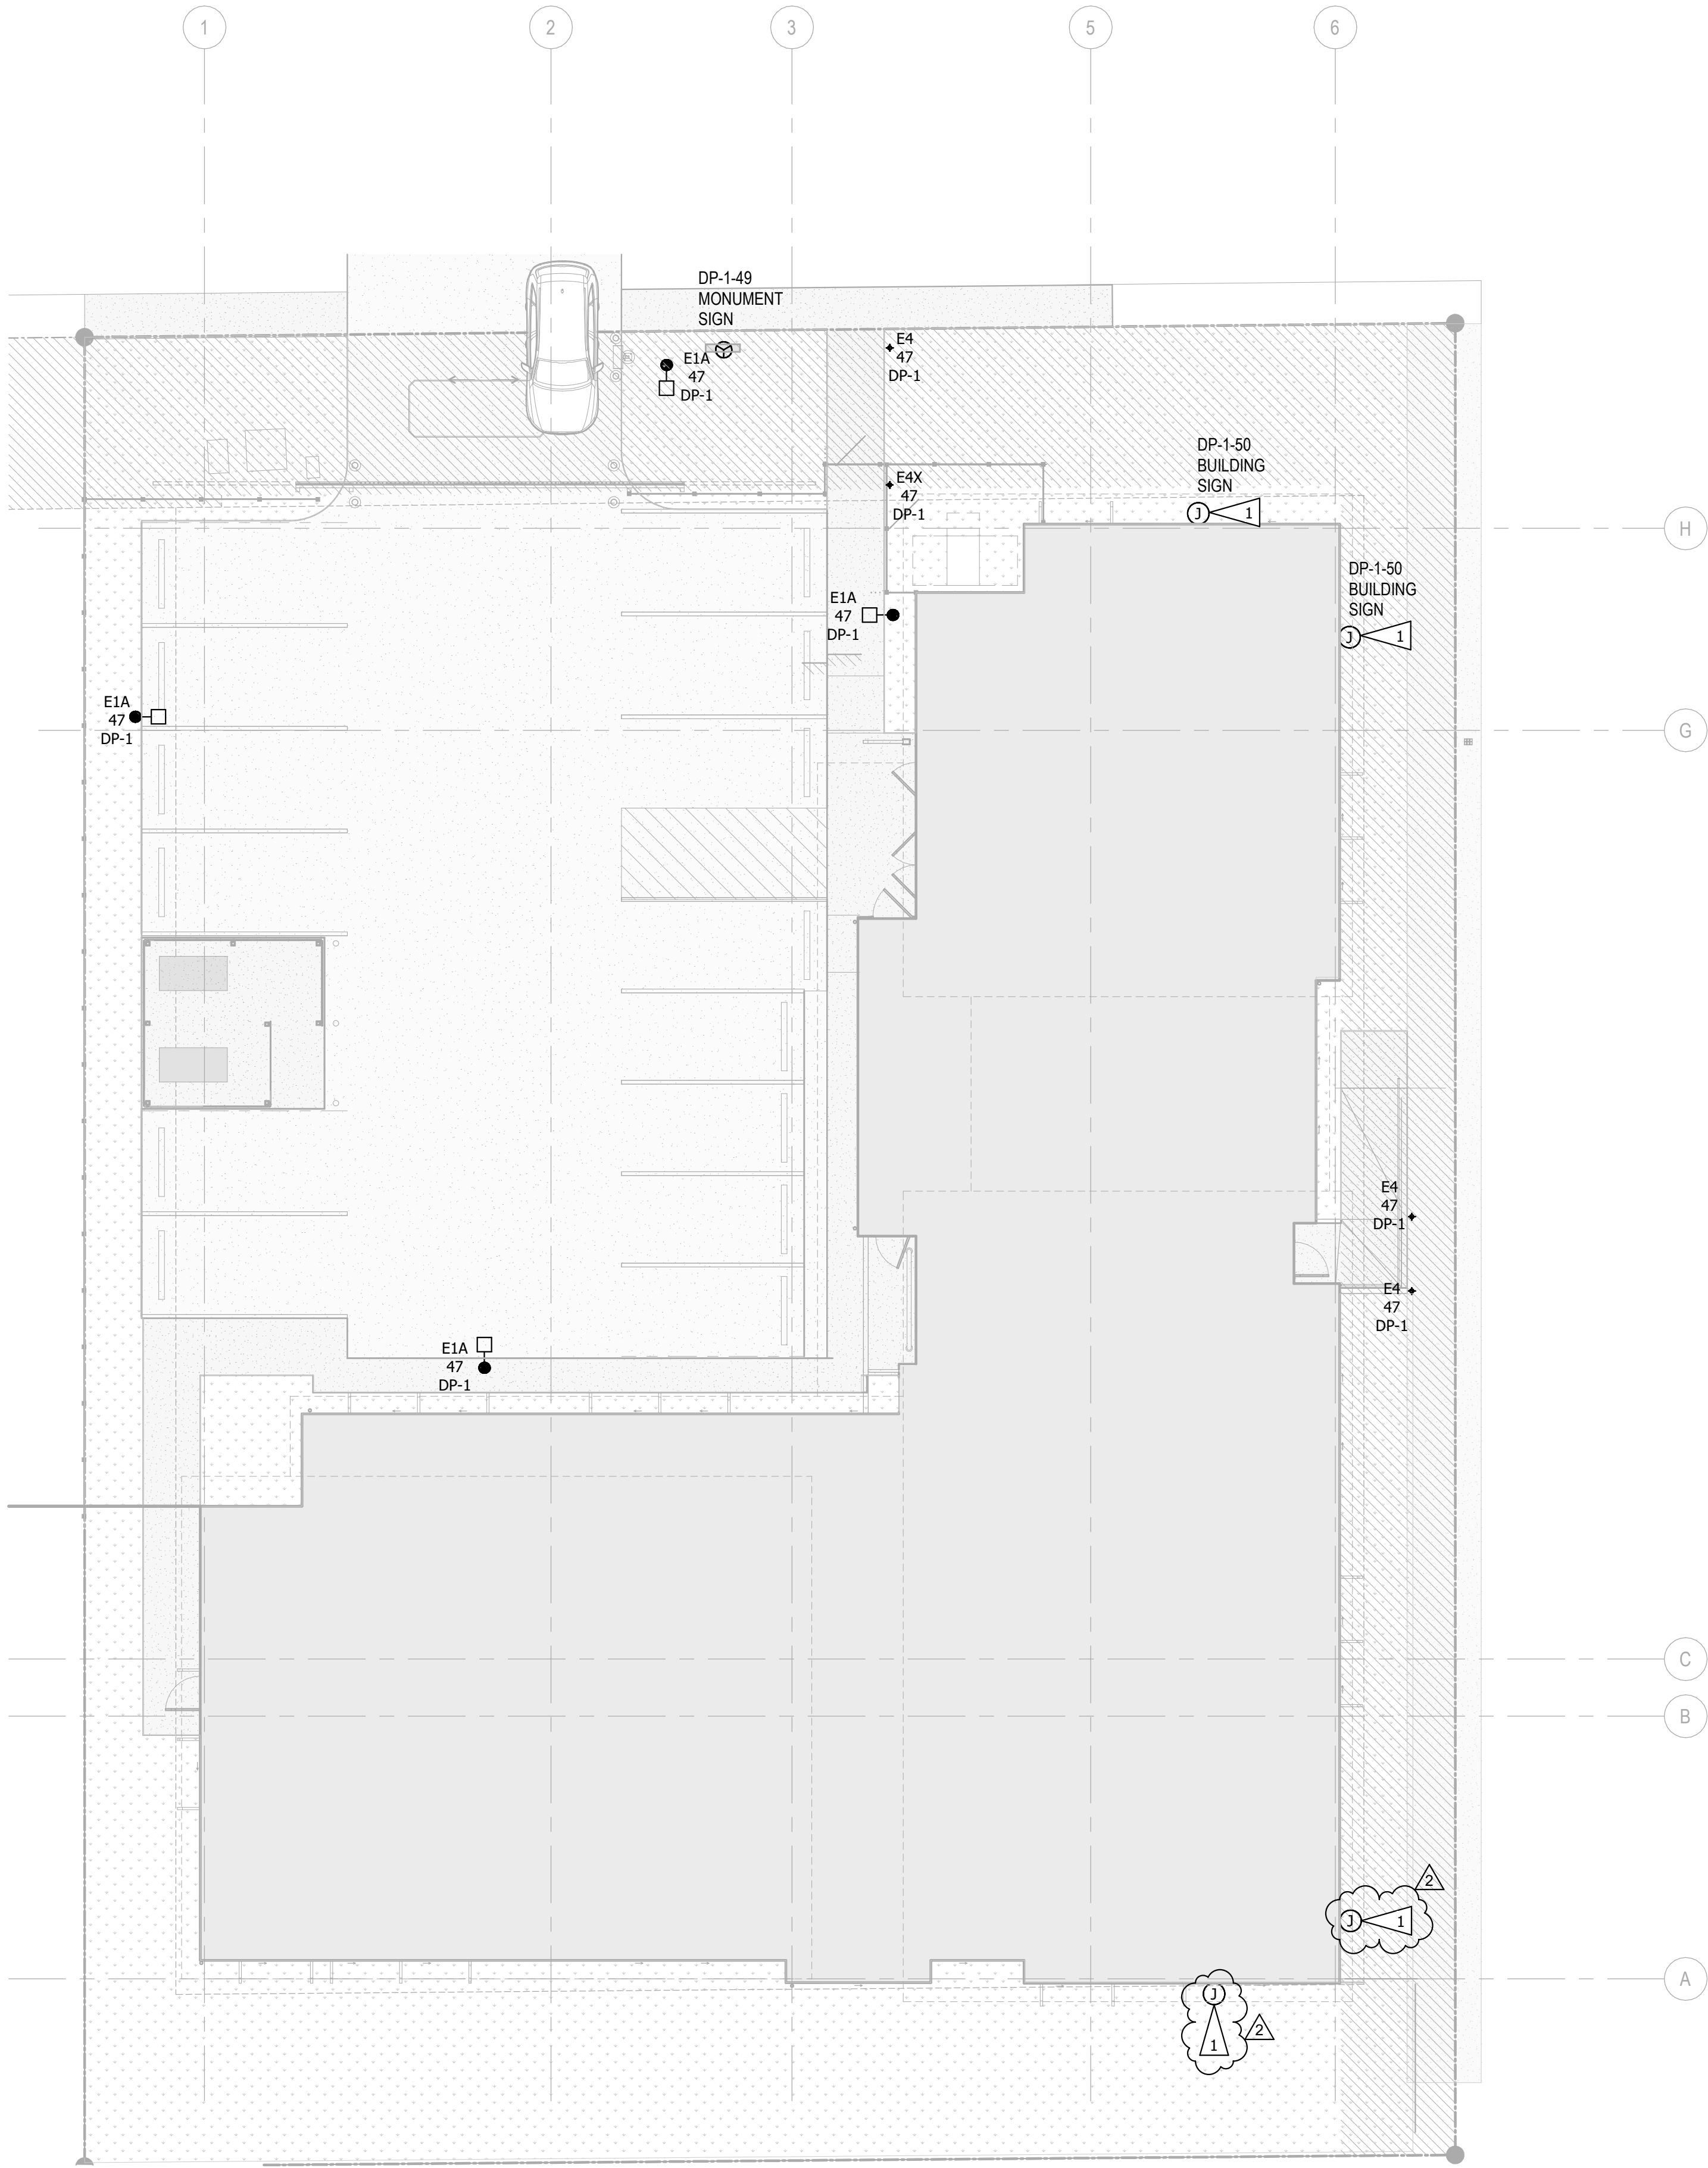

SHEET KEYNOTES

- 1 PROVIDE 120V CIRCUIT FOR BUILDING SIGNS. FINAL LOCATIONS AND ELEVATIONS TO BE COORDINATED WITH THE OWNER.

RICEfergusMILLER

ARCHITECTURE INTERIORS PLANNING VIZLAB

275 FIFTH STREET, SUITE 100
BREMERTON, WA 98337
360-377-8773
RFMARCH.COM



www.imegcorp.com
1721 8TH AVE. N.
SEATTLE, WA 98109
P: 206.262.7100

PROJECT #24021840.00

EKLUND AT GALES
PENINSULA HOUSING AUTHORITY
2372 E 7TH AVENUE
PORT ANGELES, WAS 98362

PROJECT # 2023093.02

ADDENDUM 02

ISSUE DATE AUGUST 21, 2026

REVISION SCHEDULE

1	PERMIT SET	07/26/2026
2	ADDENDUM 02	08/21/2026

AHJ APPROVAL STAMP

LIGHTING SITE PLAN

SHEET #




E31.01

DATE/TIME PRINTED: 8/20/2026 4:04:43 PM
Autodesk Docs/Peninsula Housing Authority - EklundMEP25_24021840.00_Peninsula Housing Authority_C.rvt

1

LIGHTING PLAN - LEVEL 1

1/8" = 1'-0"

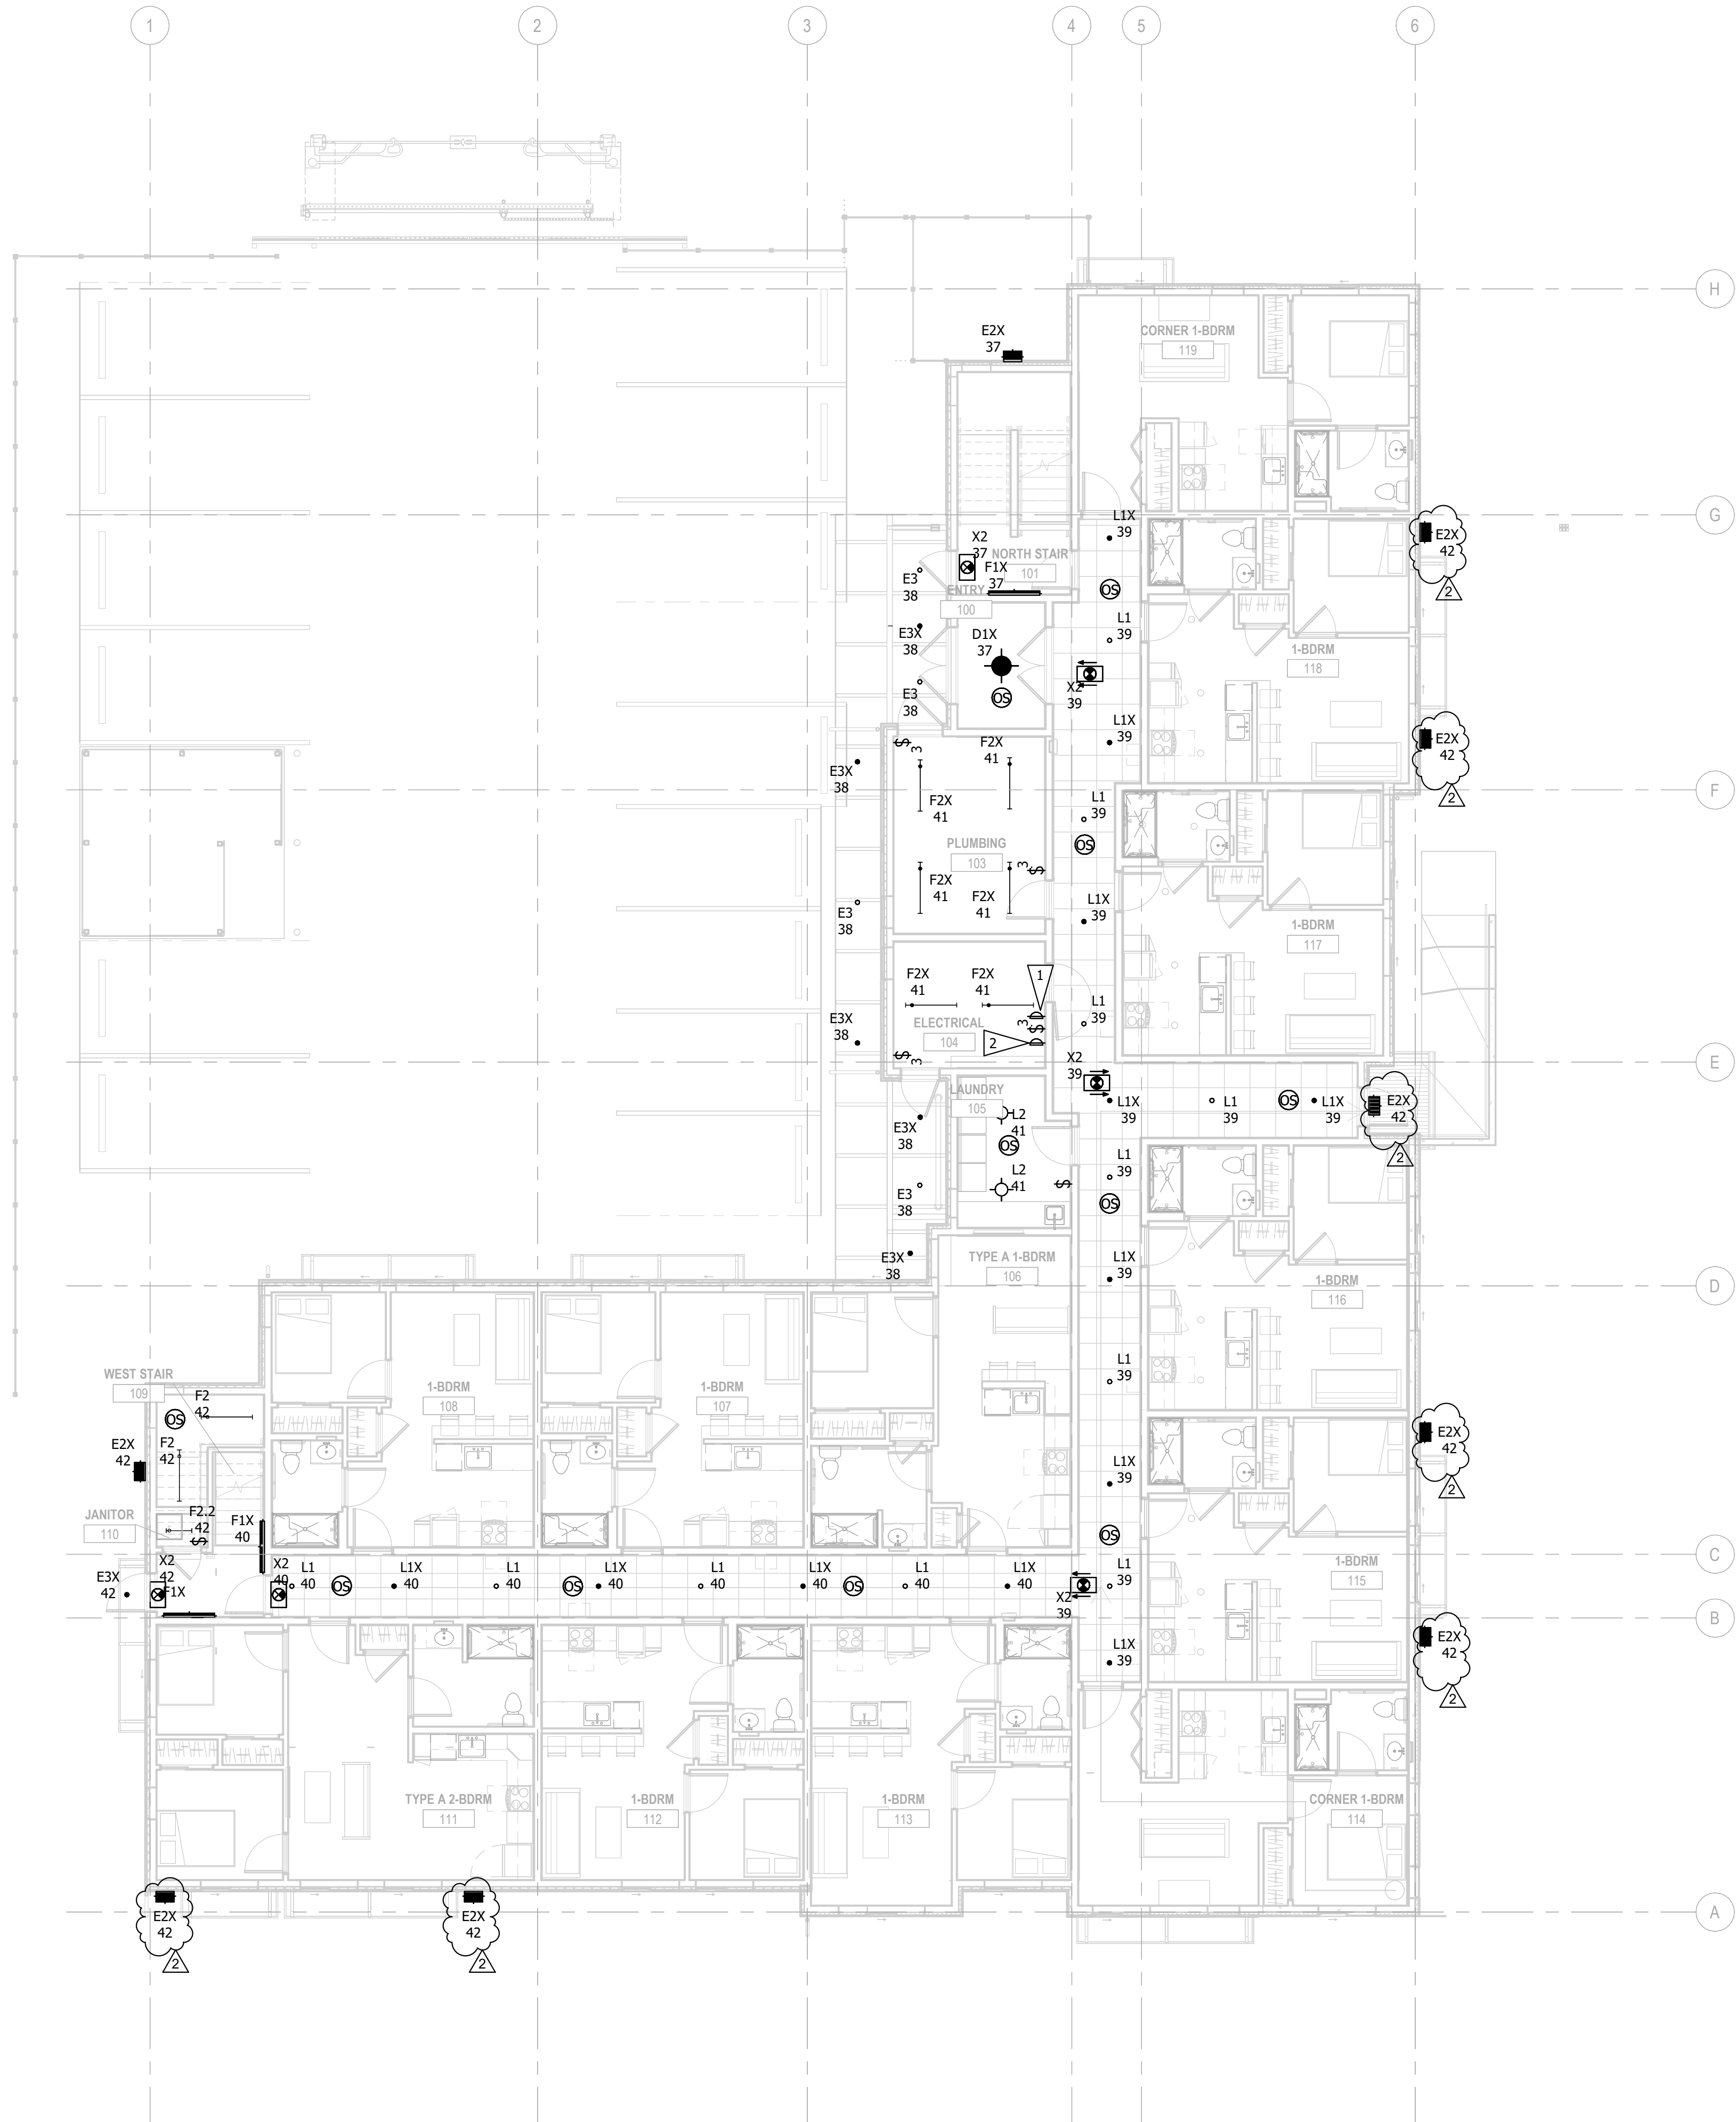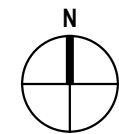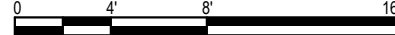

GENERAL SHEET NOTES

- LIGHTING DRAWINGS AND SCHEDULES TO BE REVIEWED IN CONJUNCTION WITH LUMINAIRE CUT SHEET PACKAGE ADDENDUM / DIVISION 26 SPECIFICATIONS.
- REFER TO SHEET E0.20 FOR LUMINAIRE SCHEDULE.
- REFER TO SHEET E0.30 FOR LIGHTING CONTROL SEQUENCE OF OPERATIONS.
- EGRESS LIGHTING, INDICATED BY "X" DESIGNATION, TO BE PROVIDED WITH UL924 BATTERY BACKUP. LIGHTING TO BE RAISED TO FULL OUTPUT DURING POWER LOSS EVENT.
- FINAL LUMINAIRE SELECTIONS AND QUANTITIES TO COMPLY WITH C406.3 PROJECT TARGETS FOR REDUCED LPD.
- REFER TO ARCHITECTURAL AND INTERIOR DRAWINGS FOR LUMINAIRE MOUNTING DETAILS. INQUIRIES REGARDING LUMINAIRE LOCATIONS AND MOUNTING DETAILS SHALL BE SUBMITTED TO THE LIGHTING DESIGNER AND ARCHITECT PRIOR TO PROCUREMENT.
- MOUNTING HEIGHTS ARE GIVEN TO BOTTOM OF LUMINAIRE, U.O.N.
- REFER TO ARCHITECTURAL LIFE SAFETY PLANS FOR EXIT SIGN LOCATIONS; FINAL LOCATIONS TO BE DOCUMENTED FOR GMP/IFC. EXIT SIGN DISTANCES NOT TO EXCEED 100LF PER IBC REQUIREMENTS.

SHEET KEYNOTES

- PROVIDE OVERRIDE DIMMER SWITCH FOR CORRIDOR LIGHTING.
- PROVIDE OVERRIDE DIMMER SWITCH FOR CORRIDOR LIGHTING.

RICEfergusMILLER
ARCHITECTURE INTERIORS PLANNING VIZLAB

275 FIFTH STREET, SUITE 100
BREMERTON, WA 98337
360-377-8773
RFMARCH.COM

IMEG
www.imegcorp.com
1721 8TH AVE. N.
SEATTLE, WA 98109
P. 206.262.7100
PROJECT #24021840.00

EKLUND AT GALES
PENINSULA HOUSING AUTHORITY
2372 E 7TH AVENUE
PORT ANGELES, WAS 98362

PROJECT # 2023093.02

ADDENDUM 02

ISSUE DATE AUGUST 21, 2026

REVISION SCHEDULE

1	PERMIT SET	07/26/2026
2	ADDENDUM 02	08/21/2026

AHJ APPROVAL STAMP

LIGHTING PLAN - LEVEL

1

SHEET #

E32.01